
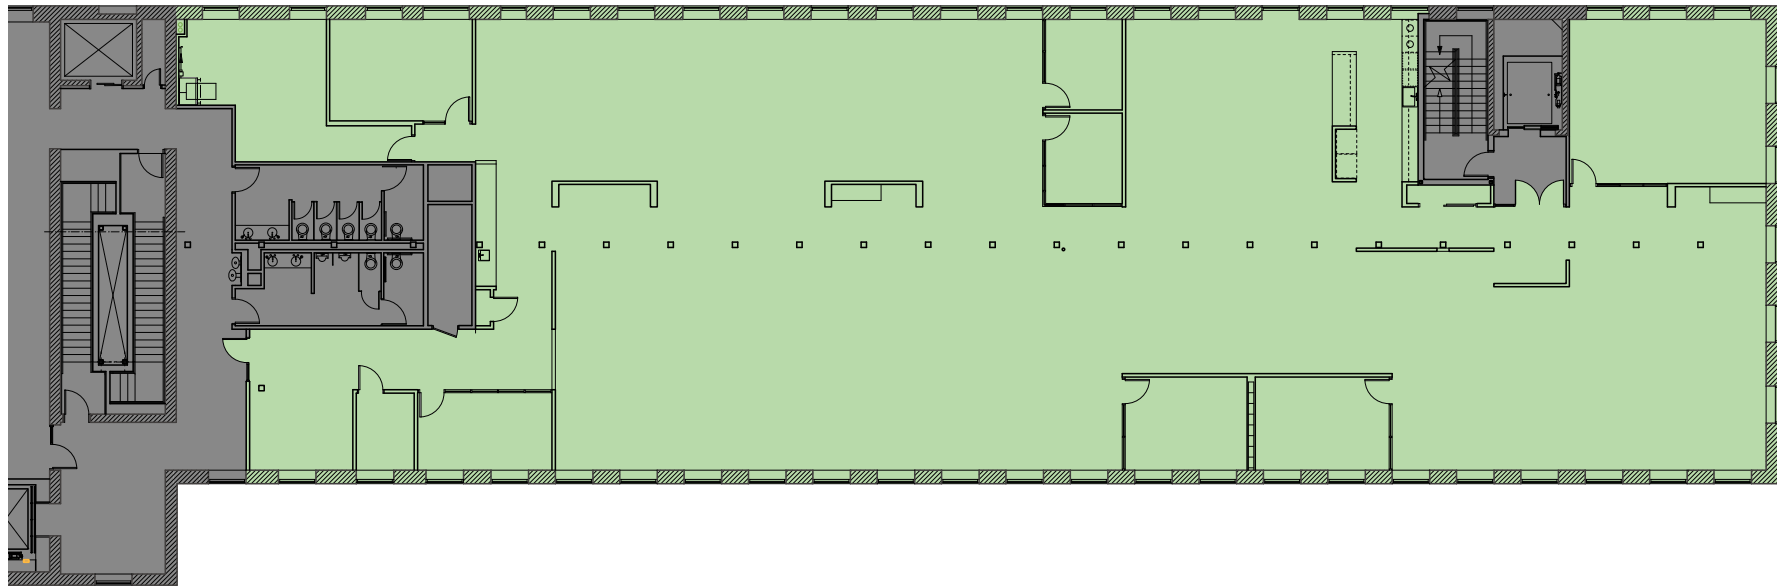


55 Chapel Street | 4th Floor | As-Built

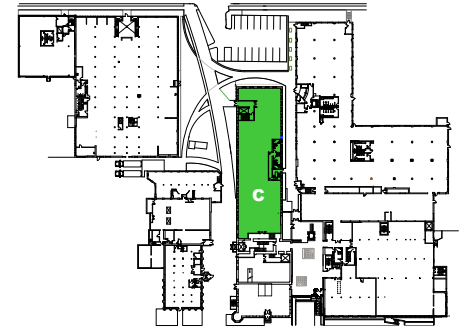

For more information or to schedule a tour, contact:

Ron Friedman

617.439.6723

ron.friedman@transwestern.com

Rob Byrne

617.933.0163

robert.byrne@transwestern.com

Chris Mullen

617.933.0177



chris.mullen@transwestern.com

Perry Beal

617.933.0043

perry.beal@transwestern.com

55 Chapel Street | 4th Floor | Furniture Plan

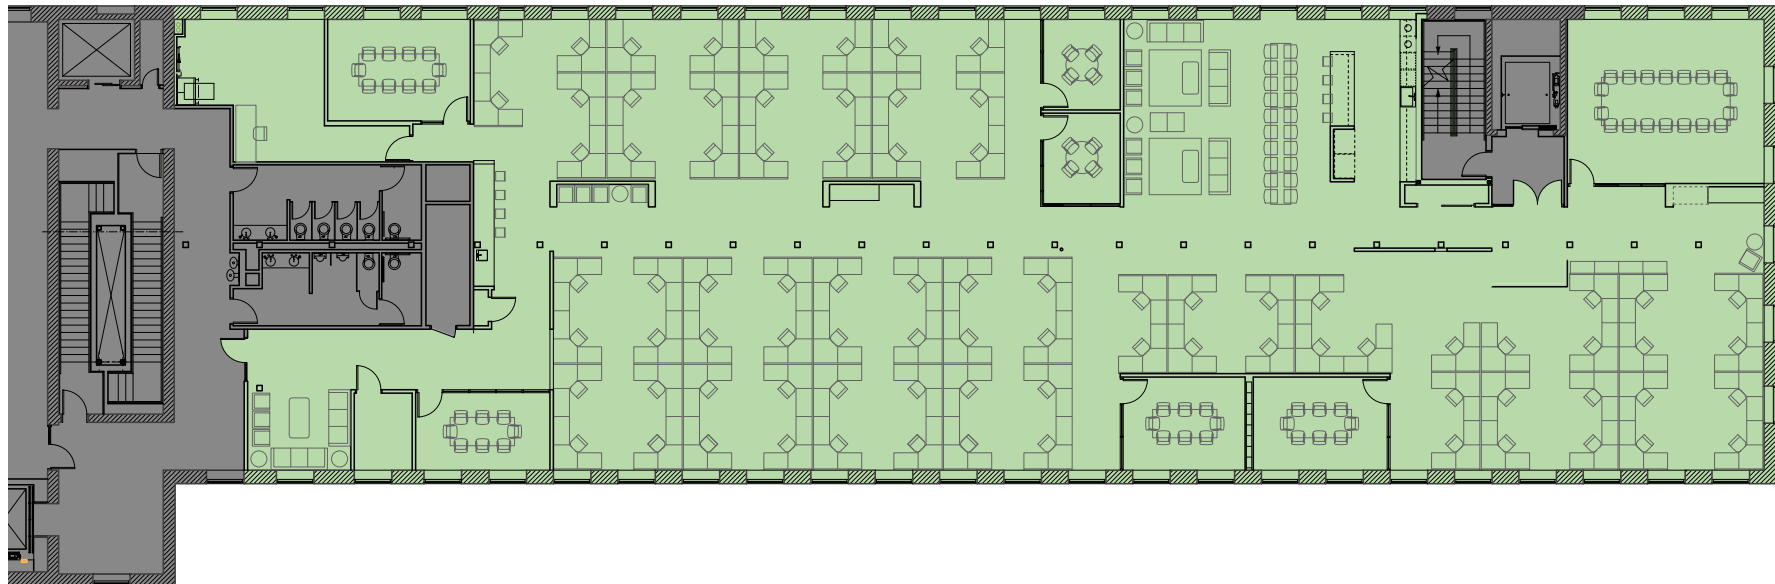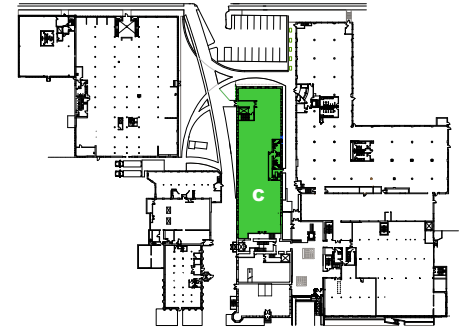

For more information or to schedule a tour, contact:

Ron Friedman
617.439.6723
ron.friedman@transwestern.com

Rob Byrne
617.933.0163
robert.byrne@transwestern.com

Chris Mullen
617.933.0177
chris.mullen@transwestern.com

Perry Beal
617.933.0043
perry.beal@transwestern.com